


Address: 1741 ROUTE 6A, EAST DENNIS Map/Parcel # 379 - 45
 Installer: B.C.K. Owner: DAVID RICCARDI
 Installation Date: 12-6-06 Permit #: 2006-0002

I certify that the sewage system installed on the above referenced lot was installed in compliance with 310 CMR 15.000, the approved design plans and all local requirements.

Installer's Signature: Brian C. Kissling Date: 12-6-06

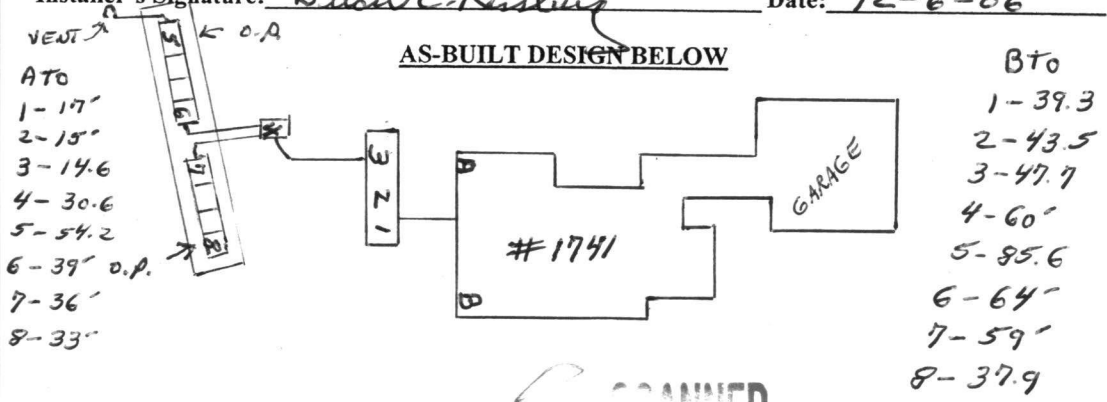

Town of Dennis Health Department

ROUTE 6A