


Address: 12 PLEASANT ST Map/Parcel # _____

Installer: J. WHITTEMORE Owner: JOHNSTON


Installation Date: 6/8/11 Permit #: BHP-2011-0348

I certify that the sewage system installed on the above referenced lot was installed in compliance with 310 CMR 15.000, the approved design plans and all local requirements.

Installer's Signature: *J. Whittemore* Date: 6/14/11

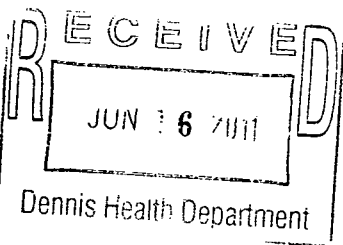

AS-BUILT DESIGN BELOW

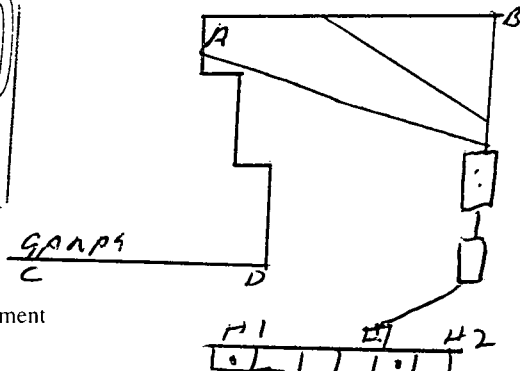

Town of Dennis Health Department

over.

A ~~TNK~~ #1 in 38.00
out 45.90

A TNK #2 in 49.40
out 57.00

B #1 TNK in 35.50
out 43.90

B #2 TNK in 47.60
out 55.60

C - P-Box 29.50
C #1 34.90
C #2 43.10

D - Box 28.50
D #1 46.00
D #2 34.60